



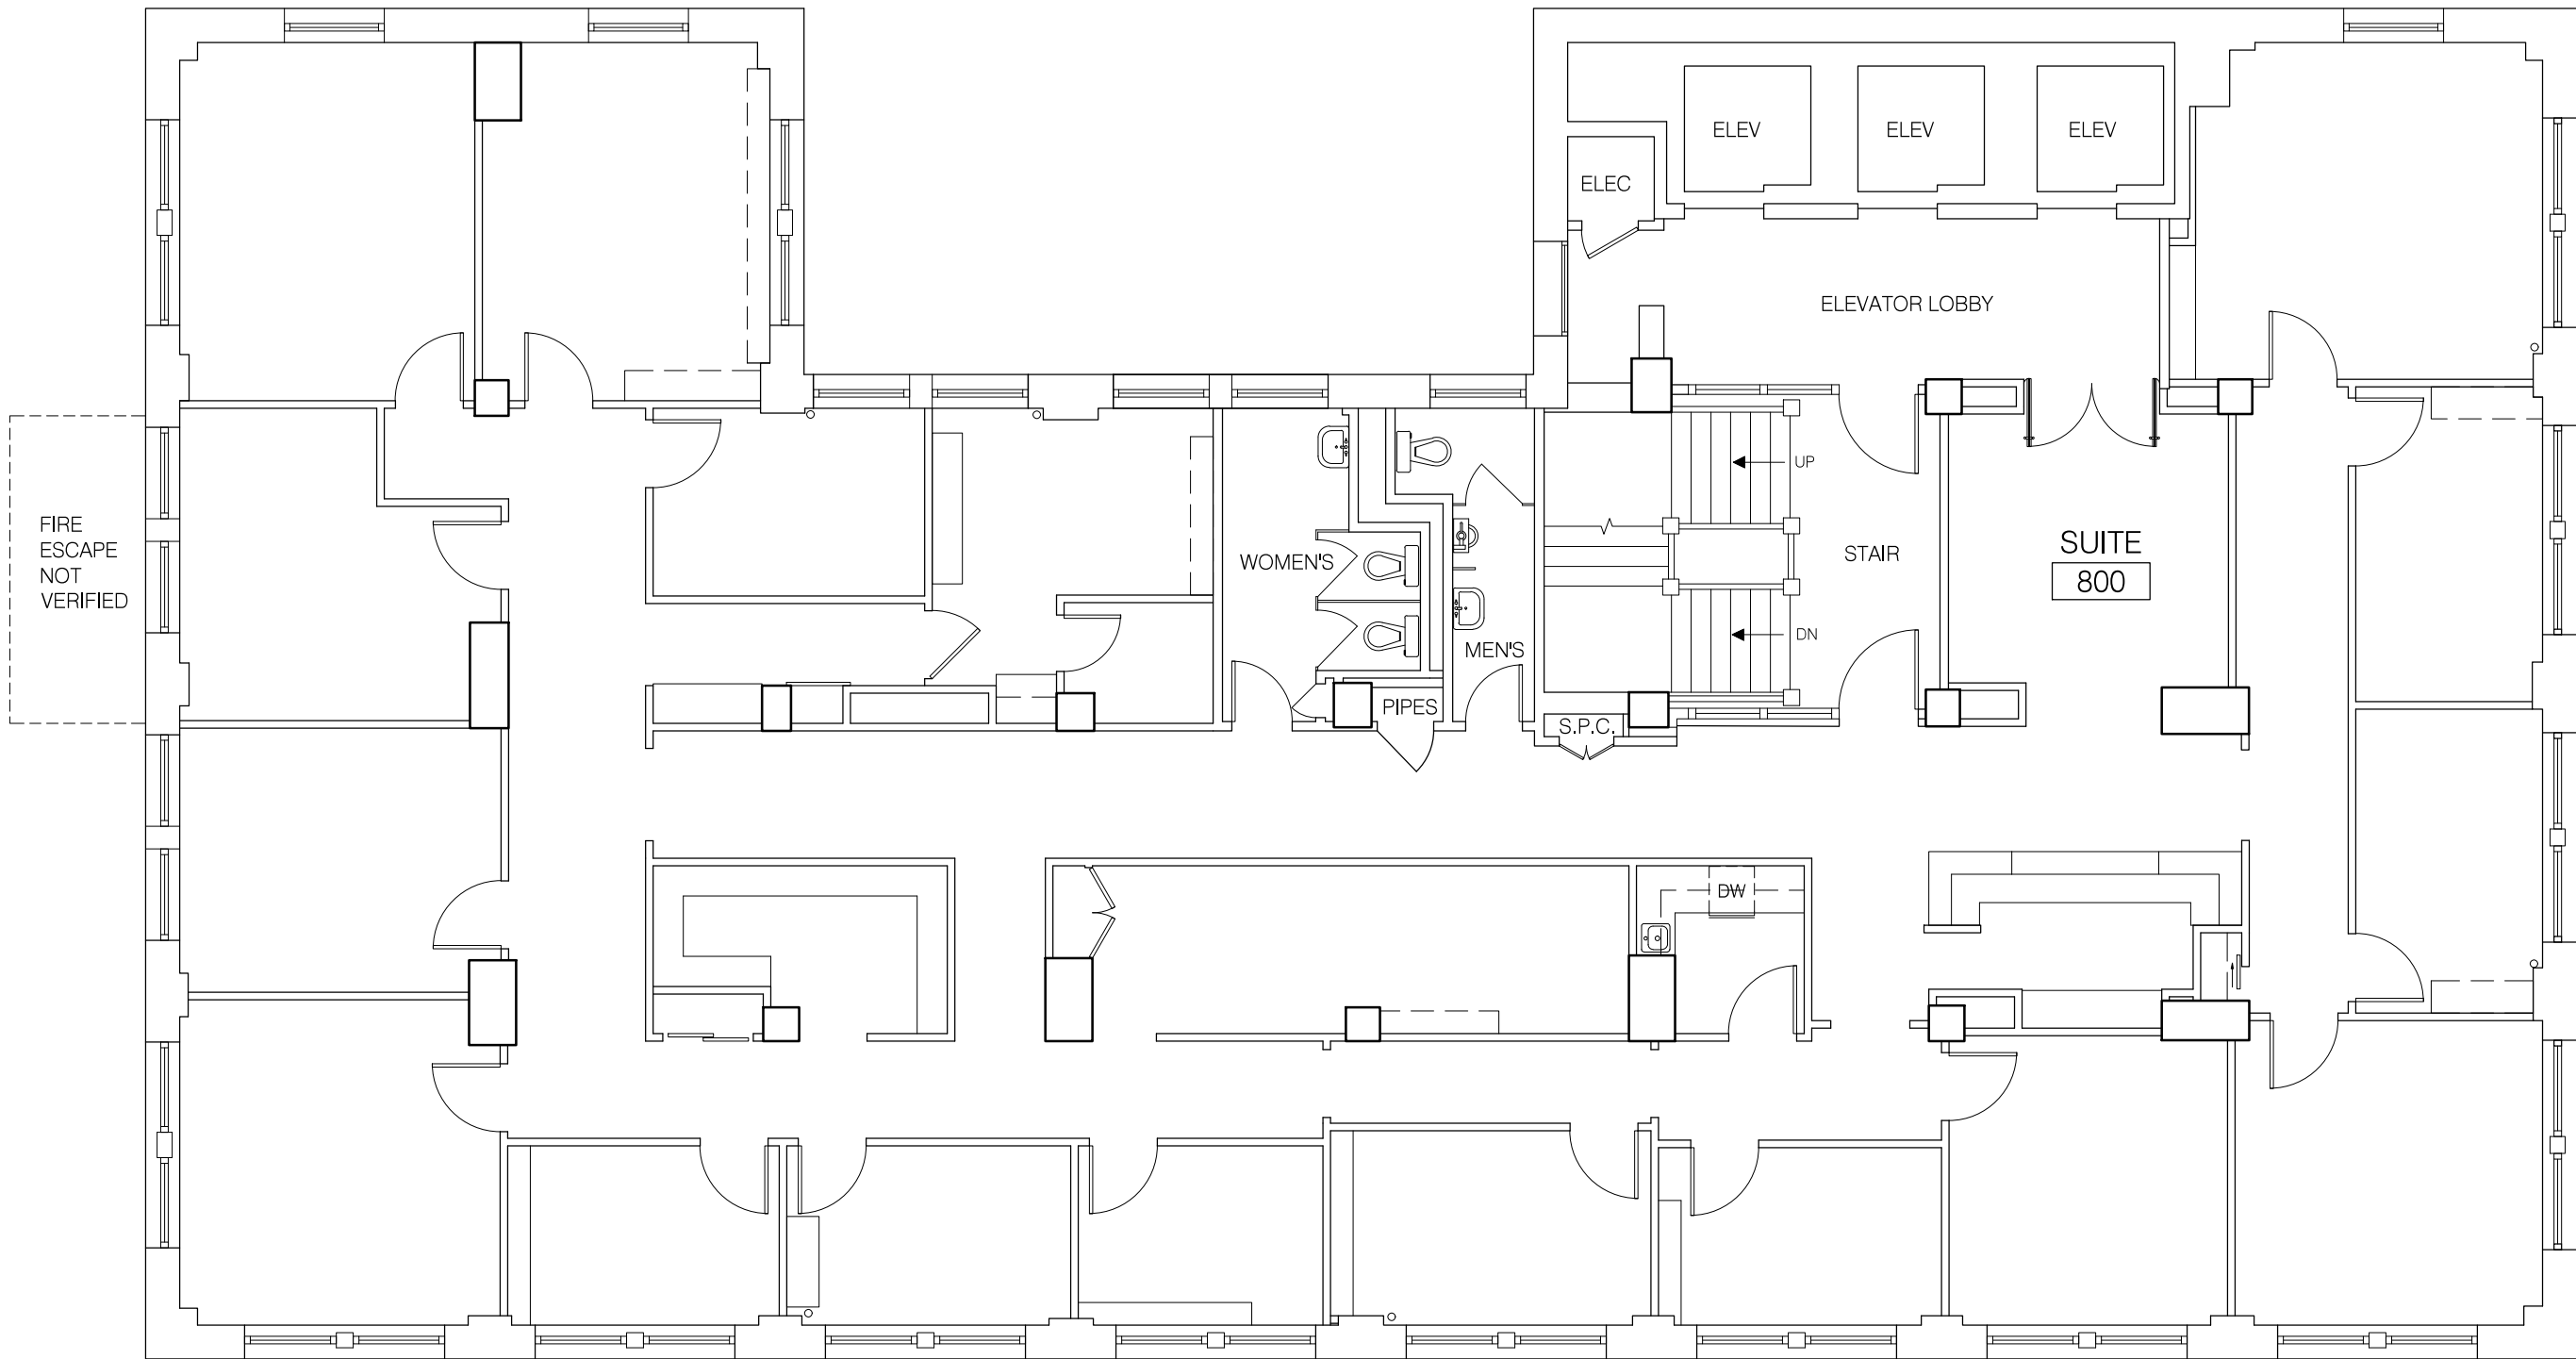

A

LEVEL 8 FLOOR PLAN

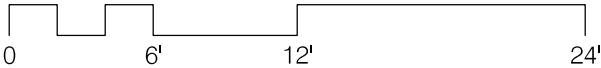

1/8" = 1'-0"



Project no:	22-086-00	Location:	HOGUE BUILDING	Issued to:	NOT FOR CONSTRUCTION	Date:	11.14.2022
	WEAVER ARCHITECTS, INC.			Scale:	1/8" = 1'-0"	Sketch No.	AS-BUILT
	PIER 55			LEVEL 8			
	1101 ALASKAN WAY, SUITE 300						
SEATTLE, WASHINGTON 98101				Drawing Notes: THIS PLAN IS INTENDED FOR SPACE PLANNING PURPOSES ONLY. THIS IS NOT TO BE USED TO GENERATE PRICING OR PRELIMINARY BUDGET WITHOUT A WORKLETTER ATTACHMENT BY WEAVER ARCHITECTS.			
P. 206.262.9622							