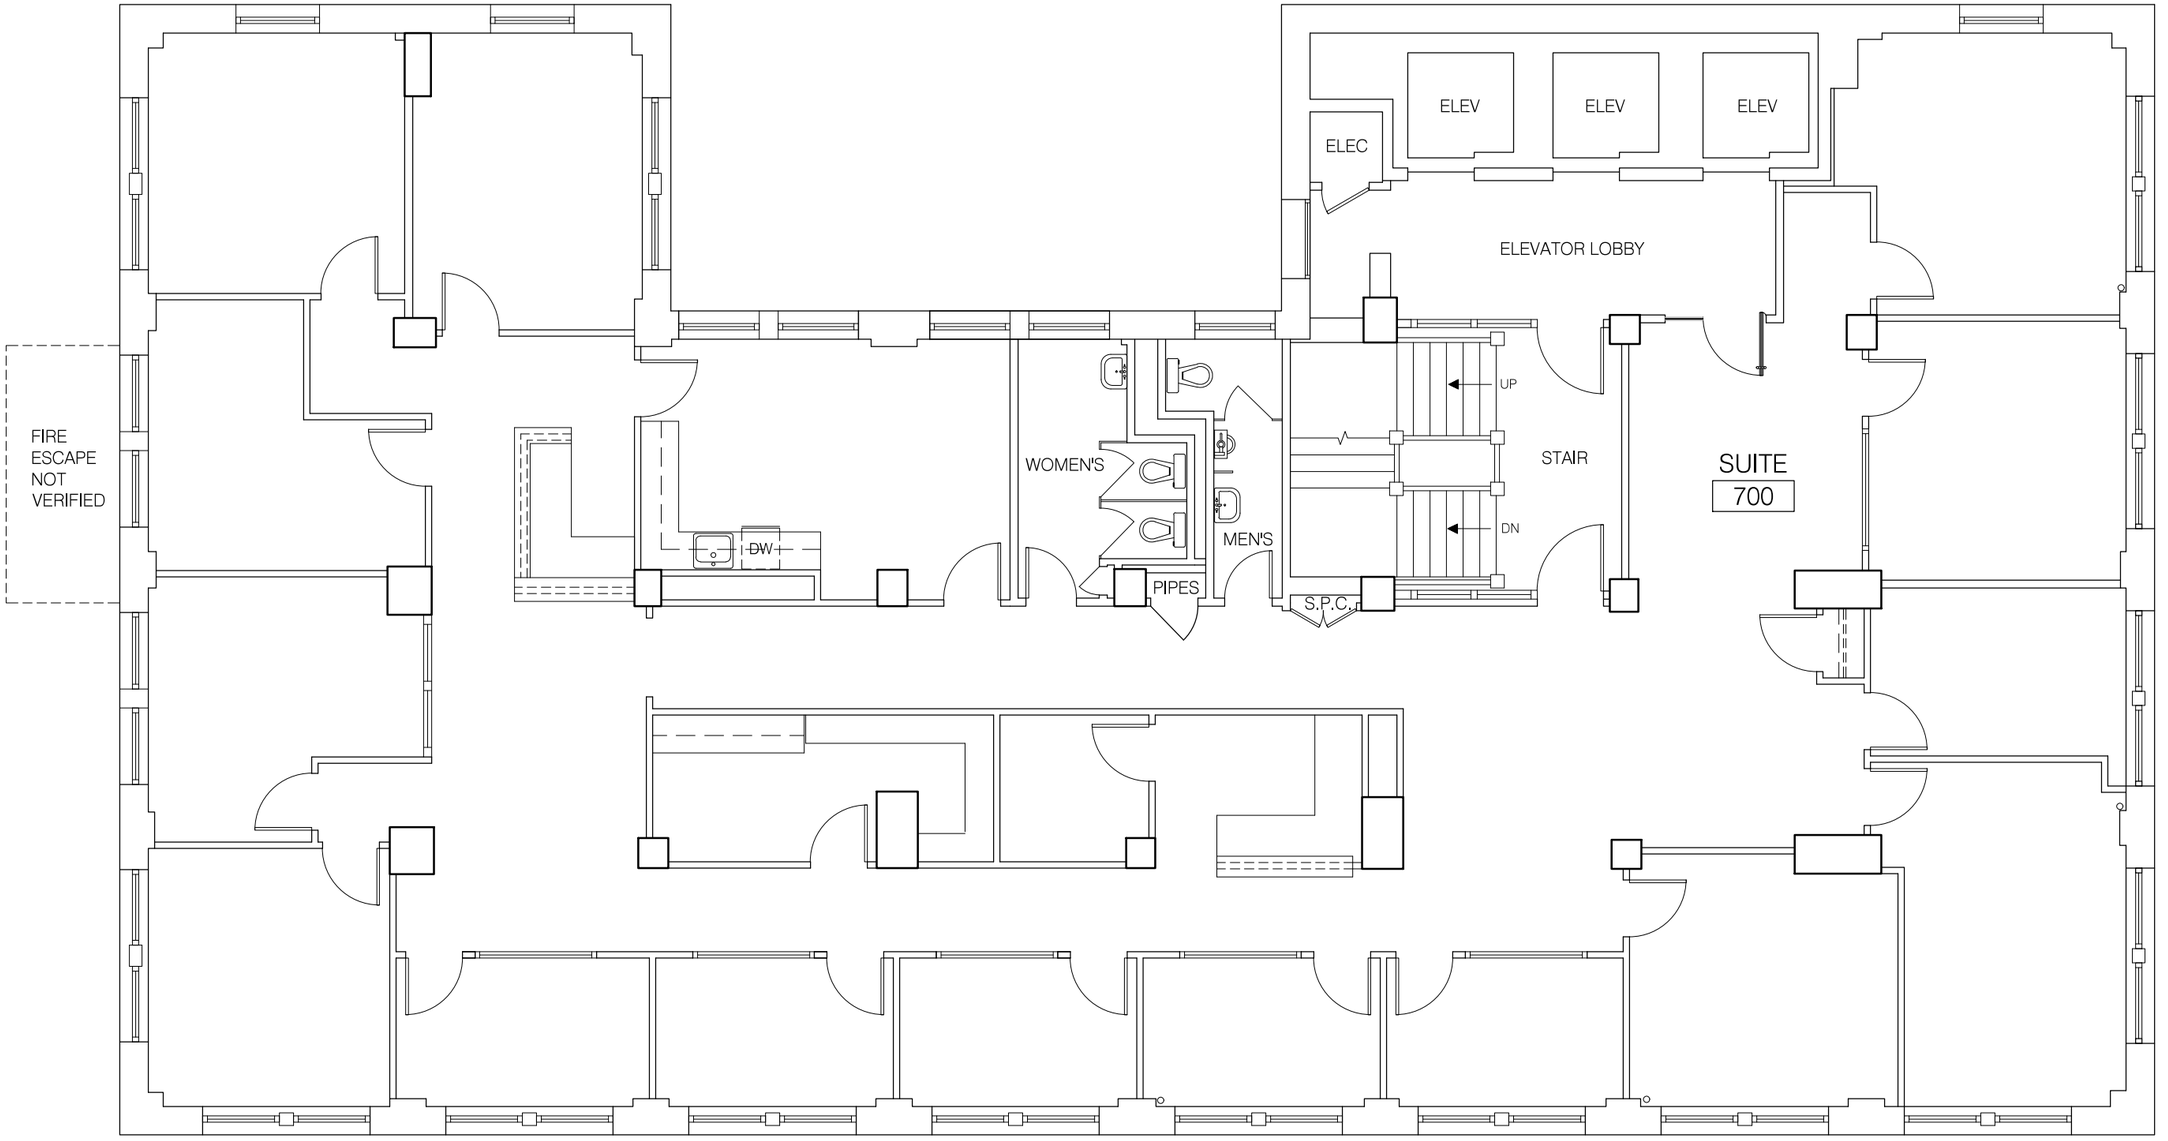

A LEVEL 7 FLOOR PLAN

0 6' 12' 24'

1/8" = 1'-0"

Project no: 22-086-00	Location: HOGE BUILDING	Issued to: NOT FOR CONSTRUCTION	Date: 11.14.2022
		Scale: 1/8" = 1'-0"	Sketch No. AS-BUILT
		Title: LEVEL 07	Drawing Notes: THIS PLAN IS INTENDED FOR SPACE PLANNING PURPOSES ONLY. THIS IS NOT TO BE USED TO GENERATE PRICING OR PRELIMINARY BUDGET WITHOUT A WORKLETTER ATTACHMENT BY WEAVER ARCHITECTS.

weaver ARCHITECTS
WEAVER ARCHITECTS, INC.
PIER 55
1101 ALASKAN WAY, SUITE 300
SEATTLE, WASHINGTON 98101
P. 206.262.9622